


AS-BUILT SURVEY
by
ANDREW SPIEWAK LAND SURVEYOR, INC.

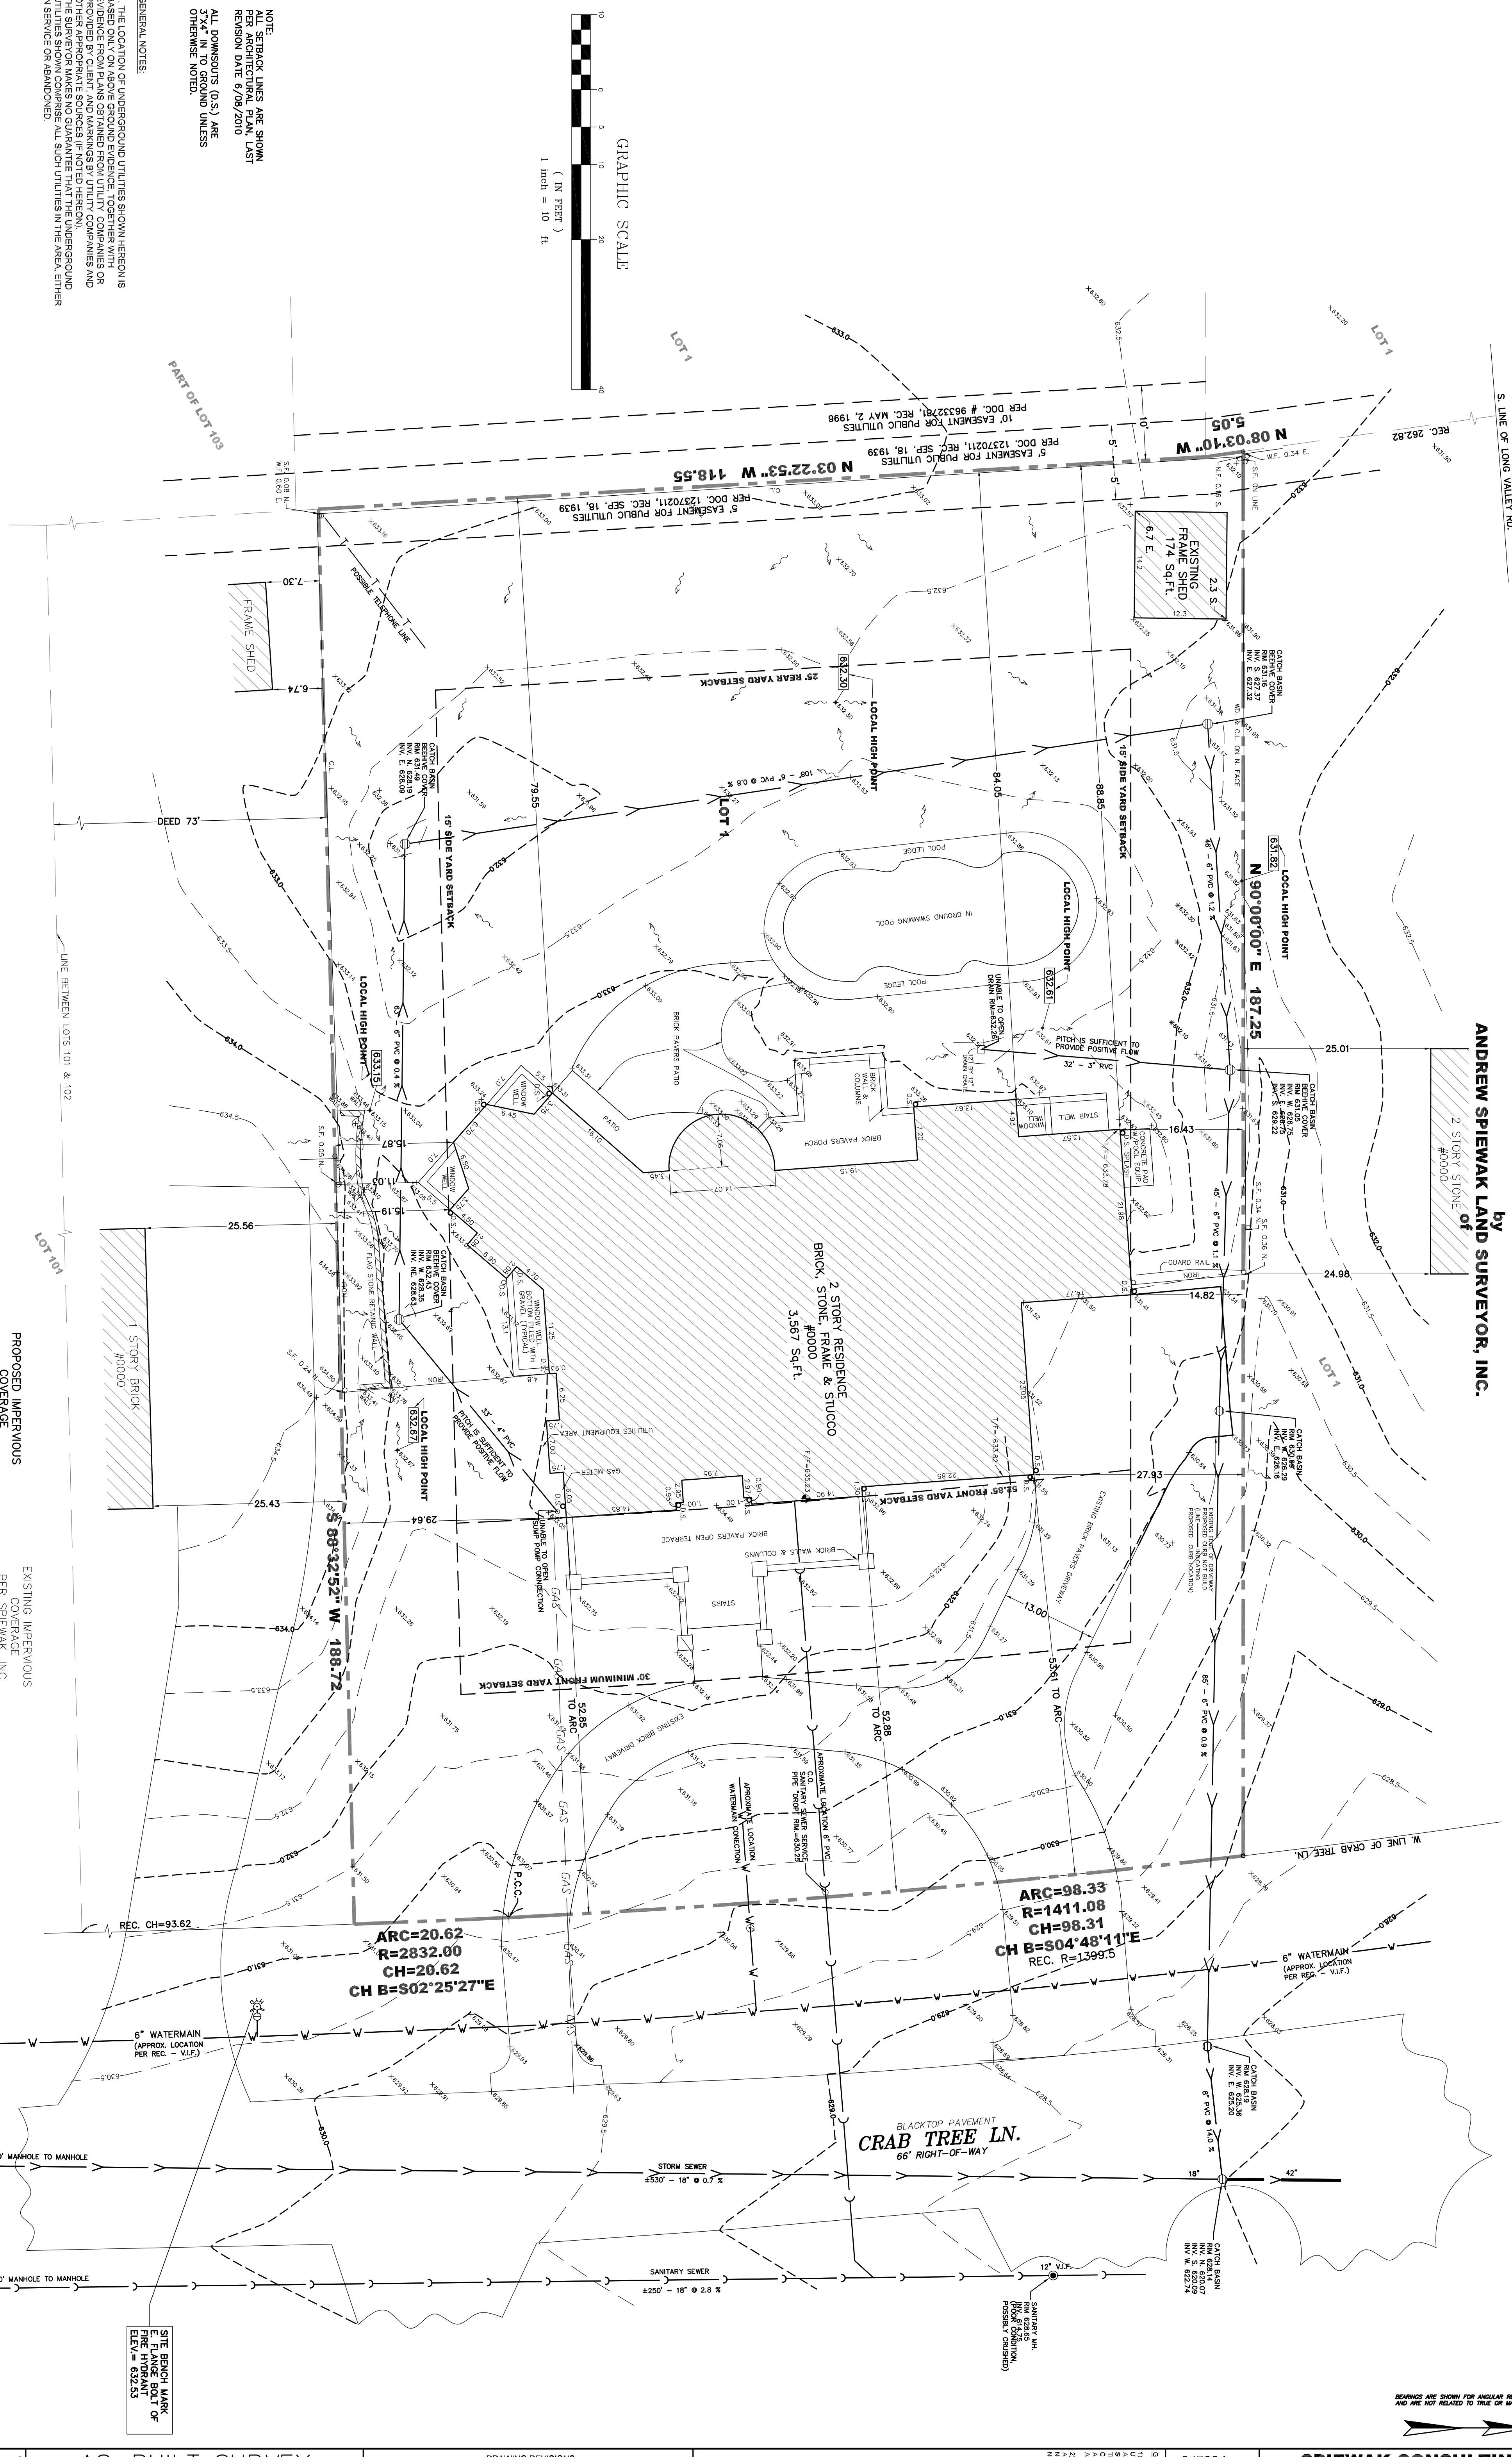

GRAPHIC SCALE
(IN FEET)
1 inch = 10 ft

- LEGEND**
- C - CURB
 - CL - CHAIN LINE
 - CM - CENTER MARK
 - CO - CONCRETE
 - CP - CEMENT PAVEMENT
 - CS - CURB SIDE
 - CS - EASEMENT
 - F - FENCE
 - FL - FLAG LINE
 - FR - FLOOR FINISH
 - FT - 5' TOP OF FINISH
 - FT - 1' TOP OF FINISH
 - FT - 6" TOP OF FINISH
 - FT - 12" TOP OF FINISH
 - FT - 18" TOP OF FINISH
 - FT - 600" TOP OF FINISH

PER ARCHITECT SITE PLAN

PROPOSED IMPROVEMENTS	EXISTING IMPROVEMENTS
HOUSE FOOTPRINT = 3581.9	HOUSE FOOTPRINT = 3587
FRONT TERRACE = 447.22	FRONT TERRACE = 489
REAR OPEN PORCH = 220.78	REAR OPEN PORCH = 230
WINDOW WELLS = 144	WINDOW WELLS = 145
DRIVEWAY = 2200	DRIVEWAY = 2185
PATIO #1 = 971	PATIO #1 = 97
PATIO #2 = 369.76	PATIO #2 = 369
POOL LEADING = 522.23	POOL LEADING = 278
STAIR WELL = 7590.69	STAIR WELL = 30
CONCRETE UTILITY PAD = 7.602	CONCRETE UTILITY PAD = 30
TOTAL = 7590.69	TOTAL = 7602

EXISTING IMPROVEMENTS

HOUSE FOOTPRINT = 3587	HOUSE FOOTPRINT = 174
FRONT TERRACE = 489	FRONT TERRACE = 489
REAR OPEN PORCH = 230	REAR OPEN PORCH = 230
WINDOW WELLS = 145	WINDOW WELLS = 145
DRIVEWAY = 2185	DRIVEWAY = 2185
PATIO #1 = 97	PATIO #1 = 97
PATIO #2 = 369	PATIO #2 = 369
POOL LEADING = 278	POOL LEADING = 278
STAIR WELL = 30	STAIR WELL = 30
CONCRETE UTILITY PAD = 30	CONCRETE UTILITY PAD = 30
TOTAL = 7602	TOTAL = 7602

PROPOSED IMPROVEMENTS

HOUSE FOOTPRINT = 3587	HOUSE FOOTPRINT = 174
FRONT TERRACE = 447.22	FRONT TERRACE = 489
REAR OPEN PORCH = 220.78	REAR OPEN PORCH = 230
WINDOW WELLS = 144	WINDOW WELLS = 145
DRIVEWAY = 2200	DRIVEWAY = 2185
PATIO #1 = 971	PATIO #1 = 97
PATIO #2 = 369.76	PATIO #2 = 369
POOL LEADING = 522.23	POOL LEADING = 278
STAIR WELL = 7590.69	STAIR WELL = 30
CONCRETE UTILITY PAD = 7.602	CONCRETE UTILITY PAD = 30
TOTAL = 7590.69	TOTAL = 7602

EXISTING IMPROVEMENTS

HOUSE FOOTPRINT = 3587	HOUSE FOOTPRINT = 174
FRONT TERRACE = 447.22	FRONT TERRACE = 489
REAR OPEN PORCH = 220.78	REAR OPEN PORCH = 230
WINDOW WELLS = 144	WINDOW WELLS = 145
DRIVEWAY = 2200	DRIVEWAY = 2185
PATIO #1 = 971	PATIO #1 = 97
PATIO #2 = 369.76	PATIO #2 = 369
POOL LEADING = 522.23	POOL LEADING = 278
STAIR WELL = 7590.69	STAIR WELL = 30
CONCRETE UTILITY PAD = 7.602	CONCRETE UTILITY PAD = 30
TOTAL = 7590.69	TOTAL = 7602

AS-BUILT SURVEY

NO.	DATE	DESCRIPTION
1		

DRAWING REVISIONS

CALL BEFORE YOU DIG

WARNING

CALL JILL TOLL FREE
1 (800) 992-0123
OR
630.415.4200
DAYS AHEAD

SPIEWAK CONSULTING
PROFESSIONAL DESIGN FIRM

5805 W. HIGGINS AVE., CHICAGO, IL 60630
phone: (773) 853-2672; fax: (773) 736-4616
www.landsurveyors.pro
andrew@landsurveyors.pro

LEGEND

SCALE: 1" = 10'
DISTANCES ARE INDICATED BY DIMENSION LINES AND SHALL BE USED TO LOCATE THE POINTS SHOWN ON THIS DRAWING UNLESS OTHERWISE NOTED.

SHEET NO. 1 OF 1

BEARINGS ARE SHOWN FOR ANGULAR REFERENCE ONLY AND ARE NOT RELATED TO TRUE OR MAGNETIC NORTH.