WETLAND DELINEATION AS-BUILT

by

ANDREW SPIEWAK LAND SURVEYOR, INC.

of

THE THE WETLAND BOUNDARY WAS DELINEATED BY PLANNING RESOURCES INC. ON AUGUST 8 AND SEPTEMBER 18, 2014 (BOUNDARY SHOWN IN RED). THE BOUNDARY WAS STAKED WITH SEQUENTIALLY NUMBERED "WETLAND DELINEATION" PIN FLAGS. THE WETLAND ON-SITE SHARES AN OBVIOUS CONNECTION TO THE DES PLAINES RIVER AND THEREFORE WILL FALL UNDER THE JURISDICTION OF THE ARMY CORPS OF ENGINEERS (ACOE). THE CORPS AND COUNTY VISITED THE SITE ON SEPTEMBER 18, 2014 AND PROVIDED VERBAL CONCURRENCE WITH THE DELINEATED WETLAND BOUNDARY.

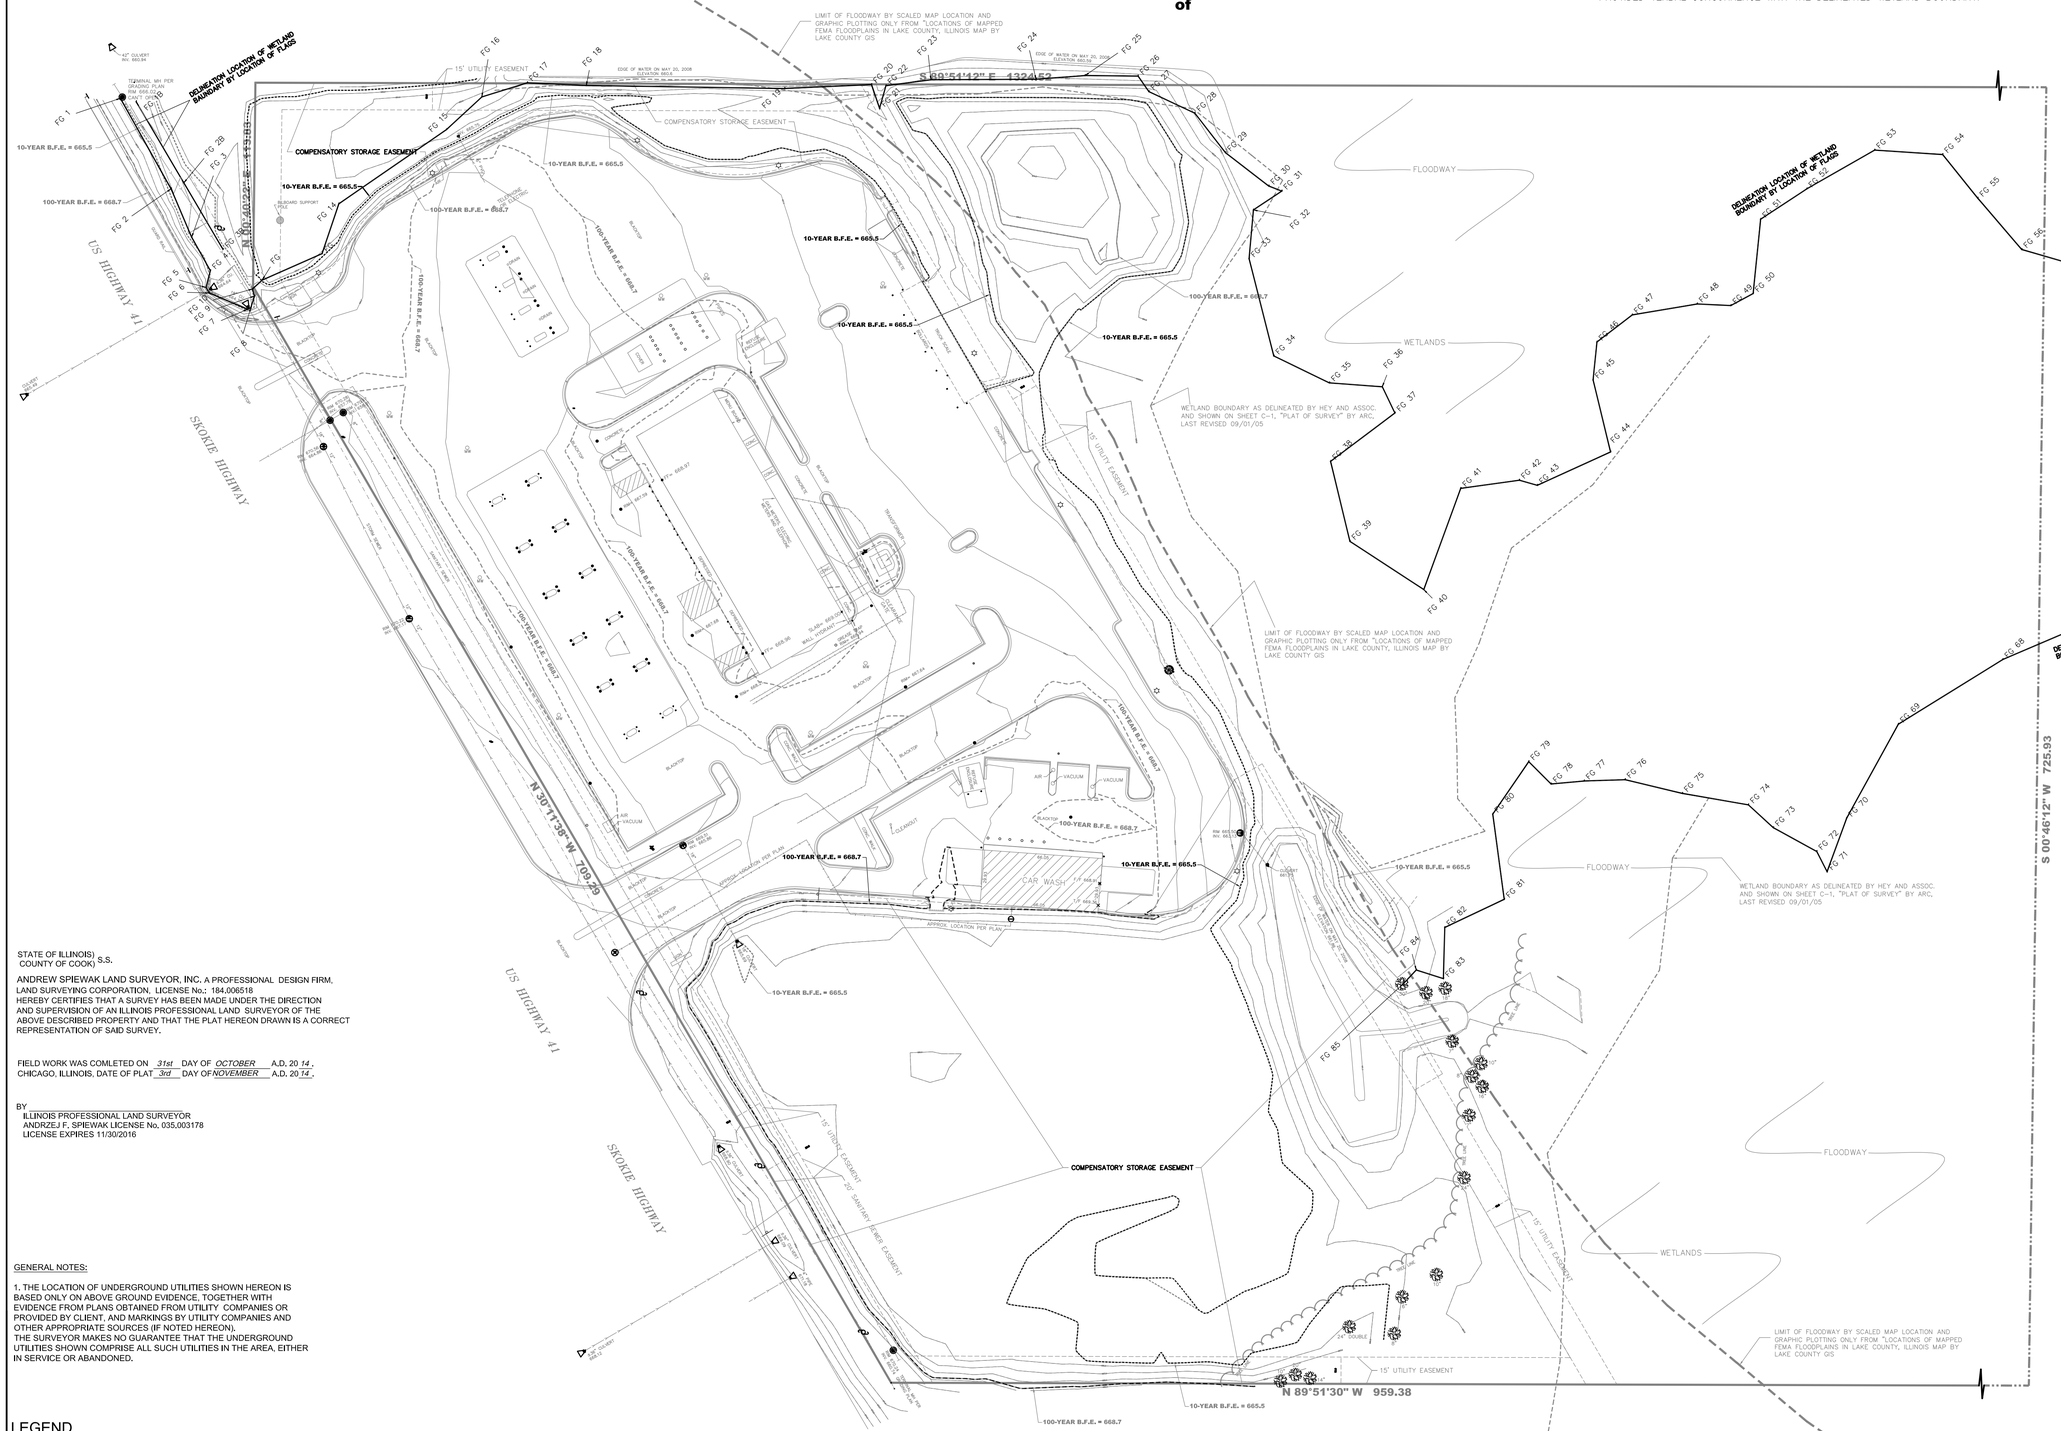

STATE OF ILLINOIS)
COUNTY OF COOK) S.S.

ANDREW SPIEWAK LAND SURVEYOR, INC. A PROFESSIONAL DESIGN FIRM, LAND SURVEYING CORPORATION, LICENSE No.: 184.006518 HEREBY CERTIFIES THAT A SURVEY HAS BEEN MADE UNDER THE DIRECTION AND SUPERVISION OF AN ILLINOIS PROFESSIONAL LAND SURVEYOR OF THE ABOVE DESCRIBED PROPERTY AND THAT THE PLAT HEREON DRAWN IS A CORRECT REPRESENTATION OF SAID SURVEY.

FIELD WORK WAS COMLETED ON *31st* DAY OF *OCTOBER* A.D. 20 *14*,
CHICAGO, ILLINOIS, DATE OF PLAT *3rd* DAY OF *NOVEMBER* A.D. 20 *14*.

BY
ILLINOIS PROFESSIONAL LAND SURVEYOR
ANDRZEJ F. SPIEWAK LICENSE No. 035.003178
LICENSE EXPIRES 11/30/2016

GENERAL NOTES:

1. THE LOCATION OF UNDERGROUND UTILITIES SHOWN HEREON IS BASED ONLY ON ABOVE GROUND EVIDENCE, TOGETHER WITH EVIDENCE FROM PLANS OBTAINED FROM UTILITY COMPANIES OR PROVIDED BY CLIENT, AND MARKINGS BY UTILITY COMPANIES AND OTHER APPROPRIATE SOURCES (IF NOTED HEREON). THE SURVEYOR MAKES NO GUARANTEE THAT THE UNDERGROUND UTILITIES SHOWN COMPRISE ALL SUCH UTILITIES IN THE AREA, EITHER IN SERVICE OR ABANDONED.

LEGEND

C = CURB
C.L. = CHAIN LINK
CONC. = CONCRETE
DS = DOWN SPOUT
E.F. = EAST FACE
EP = EDGE OF PAVEMENT
F = FLOW LINE
F.F. = FINISH FLOOR
G = GROUND
I.P. = IRON PIPE
I.R. = IRON ROD
MEAS. = MEASURED
N.F. = NORTH FACE
O.H. = OVERHEAD
P = PAVEMENT
REC. = RECORD
S.F. = SOUTH FACE
T/S = TOP OF SLAB
T/F = TOP OF FOUNDATION
W = WALK
WD. = WOOD
W.F. = WEST FACE

CABLE TV — CTV
COMBINED SEWER
ELECTRIC LINE — E
EXIST. GRADE/CONTOUR — XXX.XX — XXX.X
GAS MAIN — G
OVERHEAD WIRES — O.H. WIRES
SANITARY SEWER
STORM SEWER
TELEPHONE LINE — T
WATERMAIN — W

BEEHIVE
BENCH MARK
BUMPER GUARD
CABLE TV CONTROL BOX
CATCH BASIN
CITY ELECTRIC MANHOLE
CLEAN OUT
COMBINED SEWER MANHOLE
CROSS FOUND & SET
ELECTRIC VAULT
ELECTRIC CONTROL BOX
FENCE
FIRE HYDRANT
GAS MANHOLE
GAS METER
GAS VALVE BOX
GAS VALVE VAULT
GUARD RAIL
GUY POLE
INLET
INLET ROUND
IRON ROD FOUND
IRON ROD SET
IRON PIPE FOUND
IRON PIPE SET
ITEM NUMBER
LIGHT CONTROL BOX
LIGHT POLE
MAIL BOX
MANHOLE – UNCLASSIFIED
PARKING METER
PKN. FOUND
PKN. SET
SANITARY SEWER MANHOLE
SHRUB
SIGN
STORM DRAIN MANHOLE
STORM SEWER MANHOLE
STREET LIGHT
TELEPHONE CONTROL BOX
TELEPHONE VAULT & COMMUNICATION
TRAFFIC CONTROL BOX
TRAFFIC LIGHT
TRAFFIC SIGNAL POLE
TRANSFORMER
TREE DECIDUOUS/EVERGREEN
UTILITY POLE
WALL HYDRANT
WALL LIGHT
WATER METER VAULT
WATER VALVE BOX
WATER VALVE VAULT
YARD LIGHT
DELINEATION FLAG — FG NO.

SPIEWAK CONSULTING
PROFESSIONAL DESIGN FIRM
5805 W. HIGGINS AVE. CHICAGO, IL 60630
phone: (773) 736-1344; fax: (773) 736-4616
www.surveyorsland.com
470 SHAGBARK CT., ROSELLE, IL 60172
phone: (630) 351-9489; cell: (773) 617-3433
www.landsurveyors.pro
andrzej@landsurveyors.pro

© COPYRIGHT
SPIEWAK CONSULTING
THIS DOCUMENT AS INSTRUMENT OF SERVICE REMAIN PROPERTY OF THE COMPANY AND NO PART MAY BE REPRODUCED WITHOUT WRITTEN PERMISSION OF THE COPYRIGHT OWNER.

GENERAL NOTES:

1) THE LOCATION OF UNDERGROUND UTILITIES SHOWN HEREON IS BASED ON ABOVE GROUND EVIDENCE ONLY. THE SURVEYOR MAKES NO GUARANTEE THAT THE UNDERGROUND UTILITIES SHOWN COMPRISE ALL SUCH UTILITIES IN THE AREA, EITHER IN SERVICE OR ABANDONED.

2) BEARINGS (IF SHOWN) ARE FOR ANGULAR REFERENCE ONLY AND ARE NOT RELATED TO TRUE OR MAGNETIC NORTH.

CALL JULIE TOLL- FREE
1 (800) 892-0123
OPERATES 24 HOURS A DAY 365 DAYS A YEAR

WARNING
CALL BEFORE YOU DIG
CALL
1 (800) 892-0123
48 HOURS BEFORE YOU DIG

DRAWING REVISIONS

No.	DATE	DESCRIPTION	BY
1			

WETLAND DELINEATION

2301 N. US41 HIGHWAY
GURNEE, IL 60031

ORDERED BY:

SURVEYED BY: *JG, AS, EK*
DRAWN BY: *JG*
REVIEWED BY: *AFS*

ORDER No: *309-14 (08-086)*

SCALE: *1" = 40'*
DISTANCES ARE MARKED IN FEET AND DECIMAL PARTS THEREOF

SHEET No.